

LABOR AND MATERIALS


Copper	} Connection		\$
Lead			
1 Curb	} Cock Valve T. S. & V.	in.	\$
1 Service box	} Short 3 1/2 x 4 1/2 Long 4 1/2 x 5 1/2 Buff or Rdway		\$
Old returned			
100 Ft. 3/4 in.	} Copper C.I. C.I.	Pipe at	\$
4			
Nipples	in. at		\$
Bushings	to in. at		\$
Red'g } Inc'g }	Coupl'gs	to in. at	\$
Union	in. at		\$
Meter	in. at		\$
Lead Joints	at		\$
Compound Joints	at		\$
Maintenance Foreman			\$
Hrs. Water Maint. Man-1	at		\$
Hrs. Water Maint. Man-2	at		\$
Hrs. Garage Foreman	at		\$
Hrs. Labor	at		\$
Hrs. Compressor	at		\$
Compensation Ins. at \$	per C		\$
Trucking			\$
Pav't Patch			\$
			\$
			\$
			\$
O'head			\$
			\$

St. Pl. Ave. No. 28

LAKE AVE

Name of Owner Norman Ouellette

Labor and Mat'l. Report Nor 1978

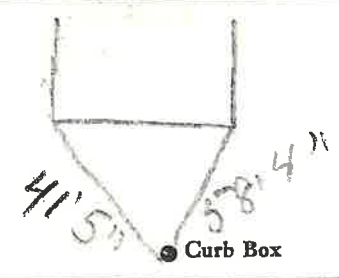

6 Main Elev. of Main at tap 5

Gate at ● Gate at ●

● Curb Box