

LABOR AND MATERIALS

Copper	} Connection	_____	\$ _____
Lead		_____	\$ _____
Curb	} Cock } Valve } T. S. & V.	_____ in.	\$ _____
Service box		} Short 3½ x 4½ } Long 4½ x 5½ } Buff or Rdway	_____
Old returned			_____
10 Ft. 3/4" in.	} Copper } G.I. } G.I.	_____	\$ _____
Nipples		_____ in. at _____	\$ _____
Bushings		_____ to _____ in. at _____	\$ _____
Red'g	} Coupl'gs	_____ to _____ in. at _____	\$ _____
Inc'g		_____	\$ _____
Union	_____ in. at _____	\$ _____	
Meter	_____ in. at _____	\$ _____	
Lead Joints	at _____	\$ _____	
Compound Joints	at _____	\$ _____	
Maintenance Foreman	_____	\$ _____	
Hrs. Water Maint. Man-1	at _____	\$ _____	
Hrs. Water Maint. Man-2	at _____	\$ _____	
Hrs. Garage Foreman	at _____	\$ _____	
Hrs. Labor	_____ at _____	\$ _____	
Hrs. Compressor	at _____	\$ _____	
Compensation Ins. at \$ _____	per C _____	\$ _____	
Trucking	_____	\$ _____	
Pav't Patch	_____	\$ _____	
_____	_____	\$ _____	
_____	_____	\$ _____	
_____	_____	\$ _____	
O'head	_____	\$ _____	
_____	_____	\$ _____	


LAKE

St. Pl. Ave. No. 4

Name of Owner

Charles Looker

Labor and Mat'l. Report June 15 1977

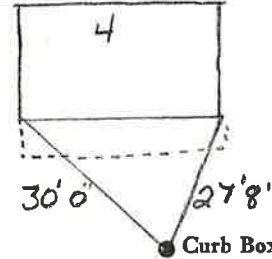

6" Main

Elev. of Main at tap _____

Gate at •

• Gate at _____

• Curb Box

✓