

LABOR AND MATERIALS


1	Copper -Lead-	Connection	3/4"	\$	_____		
1	Curb	Cock Valve T.S. & V.	3/4 in.	\$	_____		
Same	Service box Old returned	Short 3 1/2 x 4 1/2 Long 4 1/2 x 5 1/2 Buff. or Rdway	}	\$	_____		
35	Ft.					3/4 in.	{ Copper G.I. G.I.
	Nipples	in.	at	\$	_____		
	Bushings	to	in.	at	\$	_____	
	Red'g Inc'g	Coupl'gs	to	in.	at	\$	_____
	Union	in.	at	\$	_____		
	Meter	in.	at	\$	_____		
	Lead Joints	at		\$	_____		
	Compound Joints	at		\$	_____		
	Maintenance Foreman			\$	_____		
	Hrs. Water Maint. Man	1 at		\$	_____		
	Hrs. Water Maint. Man	2 at		\$	_____		
	Hrs. Garage Foreman	at		\$	_____		
	Hrs. Labor	at		\$	_____		
	Hrs. Compressor	at		\$	_____		
	Compensation Ins.	at \$ _____ per C		\$	_____		
	Trucking			\$	_____		
	Pay't Patch			\$	_____		
	<i>Tap by MOQUIN 10-27-55</i>			\$	_____		
	O'head			\$	_____		

St. \_\_\_\_\_  
Pl. \_\_\_\_\_  
Ave. No. 5

Lake

Name of Owner \_\_\_\_\_  
Utall

Labor and Mat'l. Report Oct. 27 1947

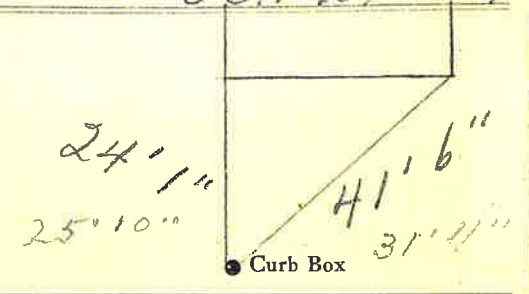

6" Main                      Elev. of  
Main at tap 5'

Gate at ●                                      ● Gate at

● Curb Box