


Labor and Materials

.. Copper } Connection.....	3	\$ 1.33
.. Lead }	4	
.. Curb { Cock Valve }	2	\$ 1.58
.. Service Box { Short 3/4x4 1/4 }	2	\$ 1.36
.. Old returned { Long 1 1/2x5 1/4 }		
.. 10 Ft. 3/4 in. { Copper Galv. Iron Cast Iron } Pipe at		\$ 95
.. Nipples	in. at	\$
.. Bushings	to 1/2 in. at	\$.05
.. Red'g Inc'g } Couplings.....	to	in. at
.. Union.....	in. at	\$
.. Meter.....	in. at	\$
.. Lbs. Br. Stone at		\$
.. Lbs. Sand at		\$
.. Bags Cement at		\$
.. Paving Brick { Mack Red Asphalt } at		\$
.. Lead Joints at		\$
.. Leadite Joints at		\$
.. Hrs. Foreman at		\$ 1.58
.. Hrs. Common Labor at Tapper		\$ 4.00
.. Hrs. Common Labor at		\$ 3.60
.. Hrs. Mason at		\$
.. Hrs. Masons Helper at		\$
.. Hrs. Compressor at		\$
.. Compensation Ins		\$ 29
.. Trucking		\$ 1.00
.. Builders Use of Water Patch		\$ 5.00
Total		\$ 71.04

33-24

Labor and Material Report May 15 1933

6 Lake Ave

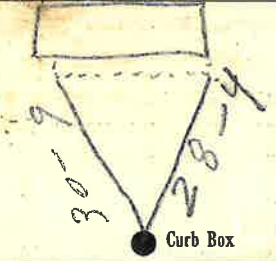

6 Main

Elev. of Main at tap 4 1/2

Gate at ●

● Gate at

● Curb Box

old Tap disconnected

OK [initials]

211