


**Labor and Materials**

.....Copper } Connection.....	3	\$ 96
.....Lead } <del>Cock</del> } .....	4	
.....Curb } <del>Yoke</del> } .....	3	\$ 1.33
.....T.S. & V. } .....	4	
.....Service Box } Short 2 1/2 x 4 1/2 } .....		
.....Old returned } Long 4 1/2 x 5 1/2 } .....		\$ 1.25
.....} Bell, or Rdway } .....		
10 Ft.....In. } Copper } Pipe at 15.....		\$ 1.50
.....} Galv. Iron } .....		
.....} Cast Iron } .....		
.....Nipples.....in. at.....		\$.....
.....Bushings.....to.....in. at.....		\$.....
.....Red'g } Couplings.....to.....in. at.....		\$.....
.....Inc'g } .....		
.....Union.....in. at.....		\$.....
.....Meter.....in. at.....		\$.....
.....Lbs. Br. Stone at.....		\$.....
.....Lbs. Sand at.....		\$.....
.....Bags Cement at.....		\$.....
.....Paving Brick } Mack } at.....		\$.....
.....} Red } .....		
.....} Asphalt } .....		
.....Lead Joints at.....		\$.....
.....Leadite Joints at.....		\$.....
7 Hrs. Foreman at.....	6 1/2	\$ 1.25
.....Hrs. Common Labor at.....		\$.....
.....Hrs. Common Labor at.....		\$.....
.....Hrs. Mason at.....		\$.....
.....Hrs. Masons Helper at.....		\$.....
.....Hrs. Compressor at.....		\$.....
.....Compensation Ins.....		\$ 1.04
.....Trucking.....		\$ 1.50
.....Builders Use of Water 1/2 Sewer.....		\$ 2.50
Total \$ 9.93		

**Labor and Material Report**

19 26

*Jake Hill*

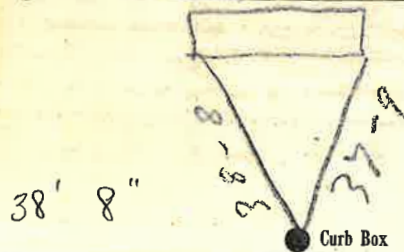

6 Main Elev. of Main at tap 4 1/2

Gate at ● TAX ID # 302.11-8-19 ● Gate at

● Curb Box

*New House*