

LABOR AND MATERIALS


Copper	Connection	\$	
Lead			
1. Curb	Cock Valve T-S & V. } 2" in.	\$	21.97
1. Service box	Short 3/4 X 4 1/2	\$	1.50
Old returned	Long 4 1/2 X 5 1/2	\$	
	Buff or Rdway	\$	10.45
11. Ft. 2 in.	Copper Pipe at	\$	95
	G. I.	\$	
	C. I.	\$	91
1. Nipples 2 in.	at Brass 3 1/2 in.	\$	
	Bushings to in.	\$	
1. Redg. Inslg	Elb Couplings 2" to 3" in.	\$	1.46
1. Union	2" in. at Adapter	\$	4.39
	Meter in.	\$	
	Lead Joints at	\$	
	Compound Joints at	\$	
2. Hrs. Water Maint. Man-1	at	\$	2.96
5. Hrs. Water Maint. Man-2	at	\$	5.10
20. Hrs. Labor	at	\$	18.20
	Hrs. Labor at	\$	
	Hrs. Compressor at	\$	
	Compensation Ins. at \$ 2.18 per C.	\$	7.0
	Trucking	\$	2.00
	Pav't Patch	\$	14.55
	Tap by Miller	\$	
	O'head	\$	
		\$	103.99

90

St. _____
Pl. _____
Ave. No. _____

Name of Owner
Lapham
First National Bank

Labor and Mat'l. Report Aug 30 1949

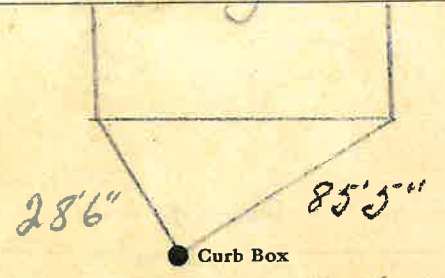

● Curb Box
Lapham Pl. side.
Elev. of Main at tap 5 1/2

3 Main Gate at ● ● Gate at

● Curb Box