

Labor and Materials

1	Copper } Connection.....	1	\$ 1.50
1	Lead }		
1	Curb { Cock }		
	{ Valve }		
	{ T.S. & V. }	2	\$ 1.70
1	Service Box { Short 3 1/2 x 4 1/2 }		
	{ Long 4 1/2 x 5 1/2 }		
	{ Buff. or Baway }		
1	Old returned		\$ 1.44
8	Ft. 3/4 in. { Copper } Pipe at		\$ 1.52
	{ Galv. Iron }		
	{ Cast Iron }		
	Nipples		\$
	Bushings		\$
	Red'g } Couplings		\$
	Inc'g }		\$
	Union		\$
	Meter		\$
	Lbs. Br. Stone at		\$
	Lbs. Sand at		\$
	Bags Cement at		\$
	Paving Brick { Mack } at		\$
	{ Red }		
	{ Asphalt }		
	Lead Joints at		\$
	Leadite Joints at		\$
7	Hrs. Foreman at	6 1/2 x	\$ 1.25
2	Hrs. Common Labor at	50	\$ 1.00
8	Hrs. Common Labor at	45	\$ 3.60
	Hrs. Mason at		\$
	Hrs. Masons Helper at		\$
2	Hrs. Compressor at		\$ 3.00
	Compensation Ins		\$ 0.21
	Trucking		\$ 1.00
	Builders Use of Water <i>Permt. P. at 1/2</i>		\$ 9.00
Total \$			25.27


50 34 ⁷⁶

Labor and Material Report

Aug

3 19³⁴

20 Lawrence St

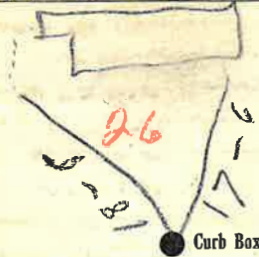

12 Main

Elev. of Main at tap 5

Gate at ● TAX ID # 303.17-1-44

● Gate at

● Curb Box

old sheet off at main

[Signature]

124