


Labor and Materials

1	Copper	Connection	3/4	\$ 1.48
1	Lead			
1	Curb	Cock Valve T.S.&V.	3/4 in	\$ 1.79
1	Service Box	Short 3 1/2 x 4 1/2		\$ 1.30
Old returned		Long 4 1/2 x 5 1/2		
8.6	Ft.	Copper Galv. Iron Cast Iron	3/4 in. Pipe at	\$ 4.48
	Nipples		in. at	\$
	Bushings		to in. at	\$
	Red'g Inc'g	Couplings	to in. at	\$
	Union		in. at	\$
	Meter		in. at	\$
	Lbs. Br. Stone		at	\$
	Lbs. Sand		at	\$
	Bags Cement		at	\$
	Paving Brick	Mack Red Asphalt	at	\$
	Lead Joints		at	\$
	Leadite Joints		at	\$
1	Hrs. Foreman		at	\$ 1.88
1	Hrs. Common Labor	Tapper	at	\$ 4.00
8	Hrs. Common Labor		at	\$ 3.60
	Hrs. Mason		at	\$
	Hrs. Masons Helper		at	\$
2	Hrs. Compressor		at	\$ 1.75
	Compensation Ins			\$ 2.90
	Trucking			\$ 1.00
	Builders Use of Water	Patch		\$ 9.00
Total				\$ 30.57

532-121 31
 Labor and Material Report Oct 10 1932

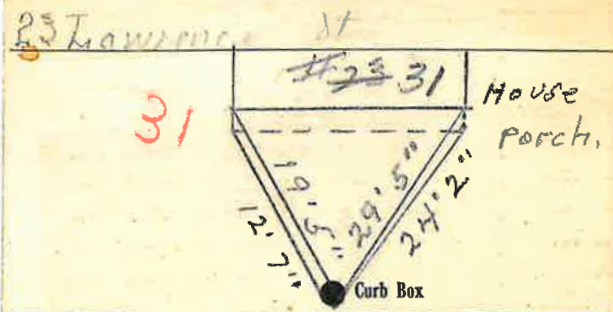

12 Main Elev. of Main at tap 4'8"

Gate at ● Gate at ●

● Curb Box

old Tap to be dug up.

TAX ID # 303.17-10-11