


Labor and Materials

Lead } Connection.....	3	\$ 133
Curb { Cock }	3	\$ 158
Service Box { Short 3 1/2 x 4 1/2 }		\$ 136
Old returned { Long 4 1/2 x 5 1/2 }		
8 Ft. 3/4 in. { Copper } Pipe at		\$ 76
Nipples		\$
Bushings		\$
Red'g Inc'g } Couplings.....		\$
Union.....		\$
Meter.....		\$
Lbs. Br. Stone at		\$
Lbs. Sand at		\$
Bags Cement at		\$
Paving Brick { Mack } at		\$
Lead Joints at		\$
Leadite Joints at		\$
3 Hrs. Foreman at		\$ 1.88
9 Hrs. Common Labor at <i>Tapper</i>		\$ 4.00
8 Hrs. Common Labor at		\$ 3.60
Hrs. Mason at		\$
Hrs. Masons Helper at		\$
3 Hrs. Compressor at <i>27 1/2</i>		\$ 2.63
Compensation Ins		\$.29
Trucking		\$ 1.-
Builders Use of Water <i>Patch</i>		\$ 9.-

Total \$ 27.43.

33-14 34 28 19 33
 Labor and Material Report *April*

26 Lawrence St

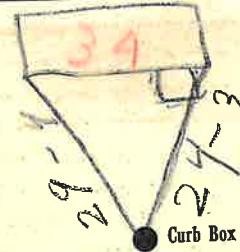

12 Main

Elev. of Main at tap 5

Gate at ●

● Gate at

● Curb Box

Old top shut off.

AK, MW

m