


LABOR AND MATERIALS

1	Copper Lead	Connection	5/4"	\$
1	Curb Valve	Cock T.S. & V.	3/4 in.	\$
Same	Service box	Short 3 1/2 x 4 1/2		
	Old returned	Long 4 1/2 x 5 1/2		
		Buff. or Rdway		\$
9	Ft. 1 in.	Copper Pipe at		\$
		G.I.		
		C.I.		
	Nipples	in. at		\$
	Bushings	to in. at		\$
	Red'g			
	Inc'g	Coupl'gs to in. at		\$
	Union	in. at		\$
	Meter	in. at		\$
	Lead Joints	at		\$
	Compound Joints	at		\$
	Maintenance Foreman			\$
	Hrs. Water Maint. Man-1	at		\$
	Hrs. Water Maint. Man-2	at		\$
	Hrs. Garage Foreman	at		\$
	Hrs. Labor	at		\$
	Hrs. Compressor	at		\$
	Compensation Ins.	at \$ per C		\$
	Trucking			\$
	Pav't Patch			\$
	Tap by Gifford Co.			\$
		9-23-57		\$
	O'head			\$

S.E. Corner Cherry & Lawrence Sts. ✓  
 Lawrence Ave. No. 37  
 St. Pl. Ave. No. 37

Name of Owner  
 V. De Santis

Labor and Mat'l. Report Sept 23 1957

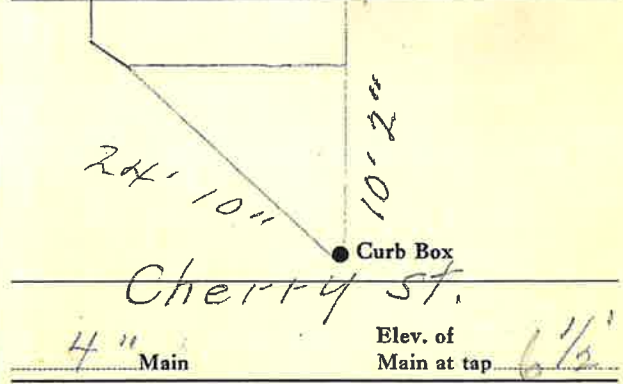

Gate at • • Gate at

• Curb Box  
 1" RENEWAL TAP - 1998