

LABOR AND MATERIALS


1 Copper } Connection 2" \$
 Lead }
 1 Curb } Cock } 2 in. Oriseal \$
 } Valve }
 } T.S. & V. }
 1 Service box } Short 3 1/2 x 4 1/2 } Oriseal Curb \$
 Old returned } Long 4 1/2 x 5 1/2 } Box \$
 } Buff or Rdway }
 49 Ft. 2 in. } Copper } Pipe at \$
 } G.I. }
 } G.I. }
 Nipples in. at \$
 Bushings to in. at \$
 Red'g } Coupl'gs to in. at \$
 Inc'g }
 Union in. at \$
 Meter in. at \$
 Lead Joints at \$
 Compound Joints at \$
 Maintenance Foreman \$
 Hrs. Water Maint. Man-1 at \$
 Hrs. Water Maint. Man-2 at \$
 Hrs. Garage Foreman at \$
 Hrs. Labor at \$
 Hrs. Compressor at \$
 Compensation Ins. at \$ per C. \$
 Trucking \$
 Pav't Patch \$
 Tap by Donovan & Bureau + Co. \$
 O'head 6-19-68 \$

Tap #1
Near Ridge St.

Lawrence St. Ave. No.

Name of Owner
Kompyr Inc.

Labor and Mat'l. Report JUNE 19 1968

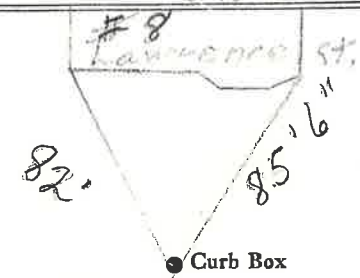

12" Main Elev. of Main at tap 5'

Gate at • Gate at

• Curb Box
Measured from
#8 Lawrence St.