

Labor and Materials


1	Copper } Connection 3/4"		\$3.20	
	Lead			
1	Curb } Cock	} 3/4" in.	\$1.00	
	Valve			
	T. S. & V.			
1	Service Box } Short 3 1/2 x 4 1/2	}	\$1.30	
	Old returned } Long 4 1/2 x 6 1/2			
		Buff. or Rdway		
27	Ft. 3/4" in. } Copper	} Pipe at	\$5.94	
				Galv. Iron
				Cast Iron
	Nipples	in. at	\$	
	Bushings	to in. at	\$	
	Red'g } Couplings	to in. at	\$	
	Inc'g			
	Union	in. at	\$	
	Meter	in. at	\$	
	Lbs. Br. Stone	at	\$	
	Lbs. Sand	at	\$	
	Bags Cement	at	\$	
	Paving Brick } Mack	} at	\$	
				Red
				Asphalt
	Lead Joints	at	\$	
	Leadite Joints	at	\$	
16	Hrs. Foreman	at	\$10.00	
1/1	Hrs. Common Labor	at 5.70	\$5.70	
1/8	Hrs. Common Labor	at 4.28	\$7.31	
	Hrs. Mason	at	\$	
	Hrs. Mason's Helper	at	\$	
1	Hrs. Compressor	at	\$1.50	
	Compensation Ins.		\$6.00	
	Trucking		\$1.00	
	Builders' Use of Water		\$	

Total \$37.35

27-164 45

Labor and Material Report Sept-20 1927

#394 wire

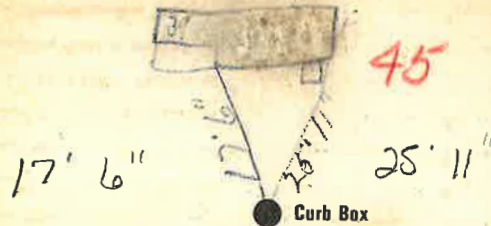

12' Main Elev. of Main at tap 45
 Gate at ● Gate at ●

● Curb Box

Old shut off

TAX ID # 303.17-11-12