

### LABOR AND MATERIALS

1	Copper	Lead	Connection	3/4	\$ 2.87
1	Curb	Cock Valve	T. S. & V.	3/4 in.	\$ 3.62
1	Service box	Short 3 1/2 X 4 1/2	Long 4 1/2 X 5 1/2		
	Old returned	Buff or Rdway			\$ —
5	Ft.	3/4 in.	Copper Pipe at	32	\$ 1.60
			G. I.		
			G. I.		
	Nipples	in. at			\$
	Bushings	to in. at			\$
	Red'g				
	Inc'g	Coupl'gs to in. at			\$
	Union	in. at			\$
	Meter	in. at			\$
	Lead Joints	at			\$
	Compound Joints	at			\$
1	Hrs. Water Maint. Man-1	at	1.12	\$ 1.12	
13	Hrs. Water Maint. Man-2	at	10.2	\$ 13.26	
18	Hrs. Labor	at	91	\$ 16.38	
	Hrs. Labor	at		\$	
2	Hrs. Compressor	at	1.20	\$ 2.40	
	Compensation Ins. at \$	per C		\$ .67	
	Trucking			\$ 2.00	
	Pav't Patch			\$ 14.85	
	Top by			\$	
	O'head			\$	
				\$ 58.77	

130

St.

Lawrence

Pl.


Ave. No. 54

Name of Owner

Di Manno

Labor and Mat'l. Report

Sept 27 1929

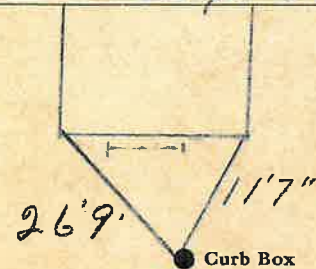

12 Main

Elev. of Main at tap 5 1/2

Gate at ●

● Gate at

● Curb Box

LBM-5C 5 18-48

To be Billed

*Handwritten signature*