


LABOR AND MATERIALS

1	Copper	Connection	1"	\$	4.28
1	Lead	Cock	1 in.	\$	5.25
1	Curb	Valve	1 in.	\$	5.25
		T. S. & V.			
1	Service box	Short 3 1/2 x 4 1/2		\$	4.69
	Old returned	Long 4 1/2 x 5 1/2		\$	
		Buff or Rdway		\$	
7	Ft. 1 in.	Copper	56	\$	39.2
		G. I.		\$	
		C. I.		\$	
	Nipples	in. at		\$	
	Bushings	to in. at		\$	
	Red'g			\$	
	Inc'g	Coupl'gs to in. at		\$	
	Union	in. at		\$	
	Meter	in. at		\$	
	Lead Joints	at		\$	
	Compound Joints	at		\$	
5	Maintenance Foreman	1.937		\$	9.69
	Hrs. Water Maint. Man	1 at		\$	
	Hrs. Water Maint. Man	2 at		\$	
5	Hrs. Garage Foreman	1.481		\$	7.41
16	Hrs. Labor	at 1.30		\$	20.80
	Hrs. Compressor	at		\$	
	Compensation Ins.	at \$5.696 per C		\$	2.15
	Trucking			\$	1.50
	Pay't Patch			\$	10.08
	Tap made	Oct 5-56		\$	
	by	Miller & Co		\$	
	O'head			\$	
				\$	69.77

59.69

St. Lawrence
 Pt. Ave. No. 60-6A

Name of Owner
 DeCrescenzo

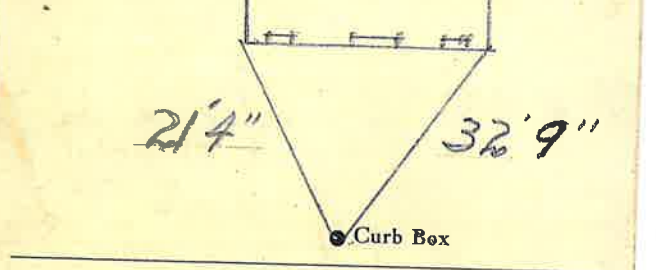

12" Main Elev. of Main at tap 4'

Gate at • Gate at

• Curb Box