


Labor and Materials

| | | | | |
|------------------------|--|-------------------------------------|-----------------------|---------|
| Copper | Lead | Connection | $\frac{3}{4}$ | \$ 7.70 |
| Curb | Cock Valve T.S. & V. | in. | $\frac{3}{4}$ | \$ 2.39 |
| Service Box | Short $3\frac{1}{2} \times 4\frac{1}{2}$ | | | \$ 1.45 |
| Old returned | Long $4 \times 5\frac{1}{2}$ | Buff. or Rdway | | |
| 31 | 25 | 3/4 in. Copper Galv. Iron Cast Iron | Pipe at $\frac{3}{4}$ | \$ 7.02 |
| Nipples | in. at | | | \$ |
| Bushings | to in. at | | | \$ |
| Red'g Inc'g | Couplings $\frac{3}{4}$ " | to in. at | | \$ |
| Union | in. at | | | \$ |
| Meter | in. at | | | \$ |
| Lbs. Br. Stone | at | | | \$ |
| Lbs. Sand | at | | | \$ |
| Bags Cement | at | | | \$ |
| Paving Brick | Mack Red Asphalt | at | | \$ |
| Lead Joints | at | | | \$ |
| Leadite Joints | at | | | \$ |
| 2 | Hrs. Foreman | at | | \$ 1.25 |
| 1.6 | Hrs. Common Labor | at | | \$ 7.70 |
| Hrs. Common Labor | at | | | \$ |
| Hrs. Mason | at | | | \$ |
| Hrs. Mason's Helper | at | | | \$ |
| Hrs. Compressor | at | | | \$ |
| Compensation Ins | | | | \$.26 |
| Trucking | | | | \$ 1.- |
| Builders' Use of Water | Patch | | | \$ 5.- |
| Total \$ | | | | 28.27 |

30-130

Labor and Material Report

19 30

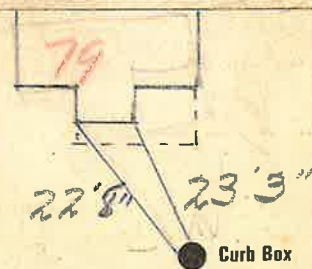

12" x 10-21-54

Main

Elev of Main at tap

4 1/2

Gate at

Gate at

Curb Box

Remove old Curbslip
& old Buffalo box
June 60