

LABOR AND MATERIALS


1. Copper	Connection	3/4	\$.	2.87
1. Lead			\$.	
1. Curb	Cock Valve	3/4 in.	\$.	3.62
	T. S. & V.				
1. Service box	Short 3 1/2 X 4 1/2	} Same	\$.	—
Old returned	Long 4 1/2 X 5 1/2				
	Buff or Rdway				
11. Ft.	3/4 in. Copper	} Pipe at	32	\$.	3.52
	G.I.				
	C.I.				
.....	Nipples	in. at	\$.	
.....	Bushings	to .. in. at	\$.	
.....	Red'g				
.....	Inc'g	Coupl'gs to .. in. at	\$.	
.....	Union	in. at	\$.	
.....	Meter	in. at	\$.	
.....	Lead Joints	at	\$.	
.....	Compound Joints	at	\$.	
.....	Hrs. Water Maint. Man—1	at	\$.	
6	Hrs. Water Maint. Man—2	at	107	\$.	6.12
12	Hrs. Labor—	at	91	\$.	10.92
.....	Hrs. Labor—	at	\$.	
.....	Hrs. Compressor	at	\$.	
.....	Compensation Ins.	at \$ 2.18 per C.	\$.	.37
.....	Trucking	\$.	2.00
.....	Pay't Patch	\$.	10.22
.....	Tap by McGowan	\$.	
.....	O'head	\$.	
					\$ 39.67

116

St.
Pl. —
Ave. No. 88

Name of Owner
Lynch

Labor and Mat'l. Report Oct 19 1919

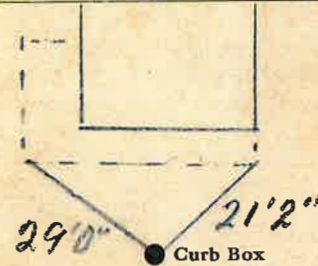

12" - 10 - 28 - 54
Main Elev. of Main at tap 17

Gate at ● Gate at ●

TAX ID # 303.17-5-17

● Curb Box