


Labor and Materials

.....	Copper } Connection ^{3/4}	\$ 1.48
.....	Lead }	
.....	Curb { Cock Valve } ^{3/4} in	\$ 1.79
..... { T.S.&V. }	
.....	Service Box { Short 3 1/2 x 4 1/2 }	\$ 1.30
.....	Old returned { Long 4 1/2 x 5 1/2 }	
..... { Bull. or Raway }	
9 Ft. ^{3/4} in. { Copper } Pipe at	\$ 1.67	
..... { Galv. Iron }	
..... { Cast Iron }	
.....	Nipples in. at	\$
.....	Bushings to 1/2 in. at 3/4	\$ 1.00
.....	Red'g } Couplings to in. at	\$
.....	Inc'g }	
.....	Union in. at	\$
.....	Meter in. at	\$
.....	Lbs. Br. Stone at	\$
.....	Lbs. Sand at	\$
.....	Bags Cement at	\$
.....	Paving Brick { Mack } at	\$
..... { Red }	
..... { Asphalt }	
.....	Lead Joints at	\$
.....	Leadite Joints at	\$
4 Hrs.	Foreman at	\$ 2.50
4 Hrs.	Common Labor at ^{Tappers}	\$ 2.00
8 Hrs.	Common Labor at	\$ 3.60
.....	Hrs. Mason at	\$
.....	Hrs. Masons Helper at	\$
.....	Hrs. Compressor at	\$
.....	Compensation Ins	\$ 25
.....	Trucking	\$ 1.00
.....	Builders Use of Water ^{Patch}	\$ 5.00
Total		\$ 20.64

5³²-129 90
 Labor and Material Report 19

64 Lawrence St

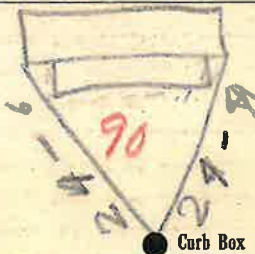

12" - 10-28-54
 Main

Elev. of Main at tap ^{5' 1/2}

Gate at ● Gate at ●

● Curb Box

OK

