

Labor and Materials


..	4	Copper	Connection.....	3	\$	96
..	..	Curb	{ Cock Valve P.S.W. }	in	\$	1.33
..	..	Service Box	{ Sheet 4 1/2 x 4 1/2 Long 4 1/2 x 5 1/2 Buff. or Red way }		\$	1.35
..	9	Ft. 3/4 in.	{ Copper Galv. Iron Cast Iron }	Pipe at 1 1/4	\$	1.35
..	..	Nipples in. at		\$	
..	..	Bushings to in. at		\$	
..	..	Red'g Inc'g	{ Couplings..... to..... in. at		\$	
..	..	Union in. at		\$	
..	..	Meter in. at		\$	
..	..	Lbs. Br. Stone	at		\$	
..	..	Lbs. Sand	at		\$	
..	..	Bags Cement	at		\$	
..	..	Paving Brick	{ Mack Red Asphalt }	at	\$	
..	..	Lead Joints	at		\$	
..	..	Leadite Joints	at		\$	
..	3	Hrs. Foreman	at	62 1/2	\$	1.88
..	4	Hrs. Common Labor	at	50	\$	2.00
..	4	Hrs. Common Labor	at	45	\$	3.60
..	..	Hrs. Mason	at		\$	
..	..	Hrs. Masons Helper	at		\$	
..	..	Hrs. Compressor	at		\$	
..	..	Compensation Ins			\$	23
..	..	Trucking			\$	1.-
..	..	Builders Use of Water	Patch		\$	5.-

Total \$18.70.

Labor and Material Report

19

32/86 92 May 26 36
66 Lawrence St

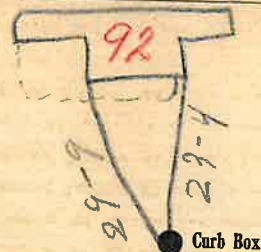

4 12" - 10-28-54

Elev. of Main at tap 52

Gate at ●

● Gate at

● Curb Box

old spot off at main