


LABOR AND MATERIALS

1	Copper	Connection	<u>3/4"</u>		\$
1	Lead	Cock			
1	Curb	Valve	<u>3/4</u> in.		\$
		T.S. & V.			
1	Service box	Short $3\frac{1}{2} \times 4\frac{1}{2}$			
	Old returned	Long $4\frac{1}{2} \times 5\frac{1}{2}$			
		Buff or Rdway			\$
8	Ft.	$\frac{3}{4}$ in.	Copper	Pipe at	\$
			G.I.		
			G.I.		
	Nipples	in. at			\$
	Bushings	to in. at			\$
	Red'g	Coupl'gs to in. at			\$
	Inc'g				
	Union	in. at			\$
	Meter	in. at			\$
	Lead Joints at				\$
	Compound Joints at				\$
	Maintenance Foreman				\$
	Hrs. Water Maint. Man-1 at				\$
	Hrs. Water Maint. Man-2 at				\$
	Hrs. Garage Foreman at				\$
	Hrs. Labor at				\$
	Hrs. Compressor at				\$
	Compensation Ins. at \$	per C			\$
	Trucking				\$
	Pav't Patch				\$
	Tap by Giescoird & Co. 7-20-59				\$
	O'head				\$

St. Lawrence
Pl. 94
Ave. No.

Name of Owner
Russell Bombard.

Labor and Mat'l. Report July 20 1959

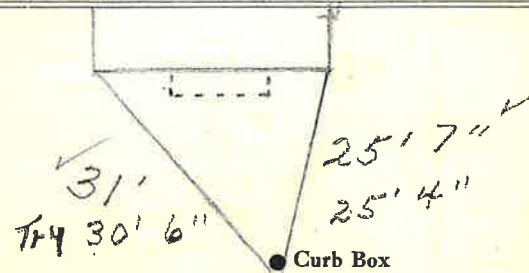

12" Main Elev. of Main at tap 6'
Gate at ● ● Gate at

● Curb Box