

## LABOR AND MATERIALS

1	Copper Lead	}	Connection	3/4"		\$
1	Curb	{	Cock Valve T. S. & V.	1"	in.	\$
Same						
	Service Box	{	Short 3 1/2 x 4 1/2			\$
	Old returned	{	Long 4 1/2 x 5 1/2			\$
			Buff for Rdway			
8'						
17	Ft.		3/4" Now			
			Cast Iron			
			Copper Galv Iron		Pipe at	\$
			Cast Iron			
	Nipples				in. at	\$
1	Bushings		1" to 3/4"		in. at Brass	\$
	Red'g Inc'g		Couplings		to in. at	\$
	Union				in. at	\$
	Meter				in. at	\$
	Lead Joints				at	\$
	Leadite Joints				at	\$
2	Hrs. Foreman				at	\$
	Hrs. Chauffeur				at	\$
2	Hrs. Tapper				at	\$
2	Hrs. Labor				at	\$
	Hrs. Labor				at	\$
	Hrs. Compressor				at	\$
	Compensation Ins.					\$
	Trucking		100			\$
No.	Builders Use of Water					\$
						\$
						\$
St. 108  
Pr  
Ave. No. 76

Lawrence

Name of Owner

August 23, 1919?

Labor and Mat'l. Report ~~SEP 5 - 1939~~ 19

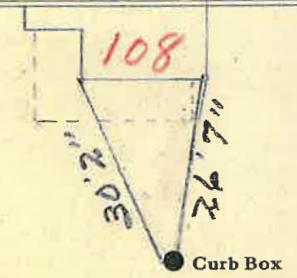

12" changed over  
4" 9-14-55

Main Elev. of Main at tap 4 1/2"

Gate at ● Gate at ●

TAX ID # 303.17-6-20

● Curb Box