

LABOR AND MATERIALS

1 Copper Connection 3/4 \$  
~~Lead~~  
 Curb { Clock Valve T.S. & V. } in. \$  
 Service box { Short 3 1/2 X 4 1/2 } \$  
 Old returned { Long 4 1/2 X 5 1/2 }  
                   { Buff or Rdway }  
15 Ft. 3 in. Galv. Iron Pipe at \$  
67 ft at Feet Copper  
 Nipples 3 in. at Feet Copper \$  
 Bushings to in. at \$  
 Red'g Inc'g } Couplings to in. at \$  
 Union in. at \$  
 Meter in. at \$  
 Lead Joints at \$  
 2 Compound Joints at 1 AT 15 Feet \$  
 Hrs. Foreman at 2 AT BOX \$  
 Hrs. Chauffeur at \$  
 Hrs. Tapper at \$  
 Hrs. Labor at \$  
 Hrs. Labor at \$  
 Hrs. Compressor at \$  
 Compensation Ins. \$  
 Trucking \$  
 Builders Use of Water \$  
 measured, in by Miller + Moquin \$  
 \$  
 \$  
 \$


111 A23

St. PF Ave. No. 79.

Lawrence

Name of Owner  
Noble's Restaurant

Labor and Mat'l. Report 4/14/09  
Feb 7 1945

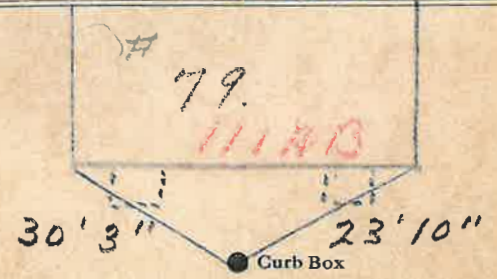

changed over.  
12" Main 9-14-55 Elev. of Main at tap 4 1/2

Gate at ● Gate at ●

PUT IN NEW  
4/14/09

● Curb Box  
~~This Tap Has Copper Connection at Main with copper Hooked to galv.~~