


LABOR AND MATERIALS

1	Copper	} Connection	3/4"	\$	
	Lead				
1	Curb	} Cock Valve T.S. & V.	3/4 in. 01-1 seat	\$	
1	Service box			} Short 3 1/2 x 4 1/2 Long 4 1/2 x 5 1/2 Buff or Rdway	\$
	Old returned				
8	Ft. 3/4 in.	} Copper G.I. C.I.	} Pipe at	\$	
	Nipples			in. at	\$
	Bushings			to in. at	\$
	Red'g } Inc'g }	} Coupl'gs	to in. at	\$	
	Union				in. at
	Meter	in. at	\$		
	Lead Joints	at	\$		
	Compound Joints	at	\$		
	Maintenance Foreman		\$		
	Hrs. Water Maint. Man-1	at	\$		
	Hrs. Water Maint. Man-2	at	\$		
	Hrs. Garage Foreman	at	\$		
	Hrs. Labor	at	\$		
	Hrs. Compressor	at	\$		
	Compensation Ins. at \$	per C	\$		
	Trucking		\$		
	Pav't Patch		\$		
	Tap by Larcourt Co.		\$		
	O'head		\$		

St. PL. Ave. No. 113
 Lawrence
 Name of Owner LAWRENCE
 Leonard Leonard

Labor and Mat'l. Report Jan. 6 19 71

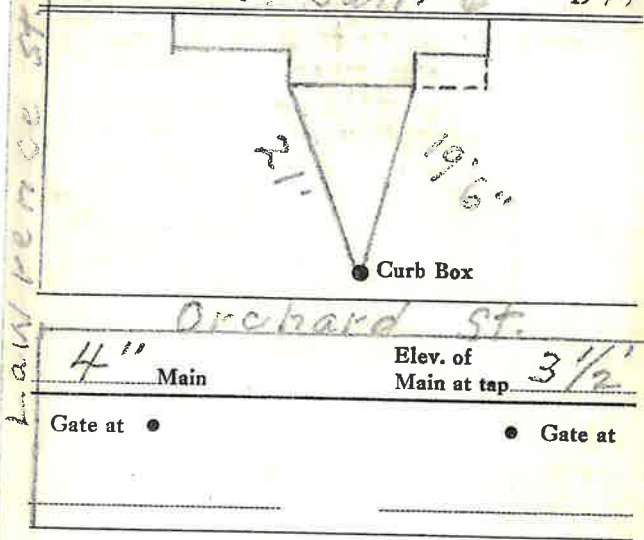

● Curb Box
 Tap on side of 4" main