


**Labor and Materials**

Copper	} Connection.....	\$. .....	
Lead			
..Curb	} Cock Valve T.S.&V. } 6x4 in .....	\$. .....	
..Service Box Old returned			} Short 3 1/2 x 4 1/2 } Long 4 1/2 x 5 1/2 } Buff. or Rdwax }
2287 Ft. 4' in.	Copper Galv. Iron Cast Iron } Pipe at .....	\$. .....	
.....Nipples	.....in. at .....	\$. .....	
.....Bushings	.....to .....	in. at .....	\$. .....
.....Red'g Inc'g	} Couplings.....to.....	in.at.....	\$. .....
.....Union.....			
.....Meter.....	in. at .....	\$. .....	
.....Lbs. Br. Stone at .....		\$. .....	
.....Lbs. Sand at .....		\$. .....	
.....Bags Cement at .....		\$. .....	
.....Paving Brick	} Mack Red Asphalt } at .....	\$. .....	
4 Lead Joints at			at 1-6" 162 lbs
.....Leadite Joints at	at joints 1-6 lbs	\$. .....	
.....Hrs. Foreman at .....		\$. .....	
.....Hrs. Common Labor at .....		\$. .....	
.....Hrs. Common Labor at .....		\$. .....	
.....Hrs. Mason at .....		\$. .....	
.....Hrs. Masons Helper at .....		\$. .....	
.....Hrs. Compressor at .....		\$. .....	
.....Compensation Ins .....		\$. .....	
.....Trucking .....		\$. .....	
.....Builders Use of Water	Patch	\$ 10. -	
28'-8" 4" Pipe			
Total		\$. .....	

40 34 116-122 Lawrence St.

Labor and Material Report

19..

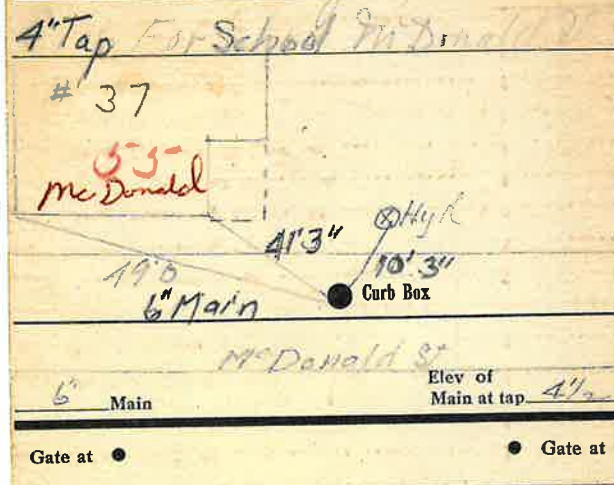

● Curb Box

New Tap 4"

Abraham Wing  
School