

## LABOR AND MATERIALS

1	Copper	Lead	Connection	3/4"	\$	2.76
1	Curb	Cock Valve	3/4 in.		\$	3.49
	Same	T. S. & V.				
	Service box	Short 3 1/2 X 4 1/2				
	Old returned	Long 4 1/2 X 5 1/2				
		Buff or Rdway				
20	Ft.	3/4 in. Copper	Pipe at	28	\$	7.60
		C.I.				
		C.I.				
	Nipples	in. at			\$	
	Bushings	to in. at			\$	
	Red'g					
	Inc'g	Coupl'gs. to in. at			\$	
	Union	in. at			\$	
	Meter	in. at			\$	
	Lead Joints	at			\$	
	Compound Joints	at			\$	
	Hrs. Water Maint. Man-1	at			\$	
	Hrs. Water Maint. Man-2	at 1.24			\$	13.64
11	Hrs. Labor	at 1.13			\$	27.12
24	Hrs. Labor	at			\$	
	Hrs. Compressor	at			\$	
	Compensation Ins. at	\$7.406 per C			\$	1.80
	Trucking				\$	1.00
	Pav't Patch				\$	20.30
	Tap by Gissard 6-19-53				\$	
	O'head				\$	


57.41  
 20.30  
 77.71

46-53

St. \_\_\_\_\_  
 Pl. \_\_\_\_\_  
 Ave. No. 15

Name of Owner Whiting

Labor and Mat'l. Report June 19 1953

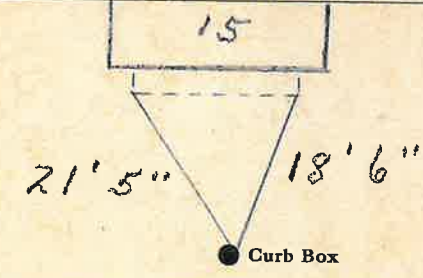

4" Main Elev. of Main at tap 4 1/2'  
 Gate at ● ● Gate at

20' to MAIN

3/4" copper ● Curb Box