


LABOR AND MATERIALS

1	Copper Lead	Connection	$\frac{3}{4}$ "	\$
1	Curb	Cock Valve	$\frac{3}{4}$ " or seal	\$
1	Service box	I. S. & V.		\$
	Old returned	Short $3\frac{1}{2}$ x $4\frac{1}{2}$		
		Long $4\frac{1}{2}$ x $5\frac{1}{2}$		
		Buff or Rdway		\$
20	Ft. $\frac{3}{4}$ in.	Copper Pipe at		\$
		G. I.		
		C. I.		
	Nipples	in. at		\$
	Bushings	to in. at		\$
	Red'g			
	Inc'g	Coupl'gs. to in. at		\$
	Union	in. at		\$
	Meter	in. at		\$
	Lead Joints at			\$
	Compound Joints at			\$
	Maintenance Foreman			\$
	Hrs. Water Maint. Man-1 at			\$
	Hrs. Water Maint. Man-2 at			\$
	Hrs. Garage Foreman at			\$
	Hrs. Labor at			\$
	Hrs. Compressor at			\$
	Compensation Ins. at \$	per C		\$
	Trucking			\$
	Pav't Patch			\$
	Tap by Lareau & Co			\$
				\$
				\$
	O'head			\$

Lawton St. No. 17  
 Ave. No. 17

Name of Owner  
 Petrosky.

Labor and Mat'l. Report July 22 1964.

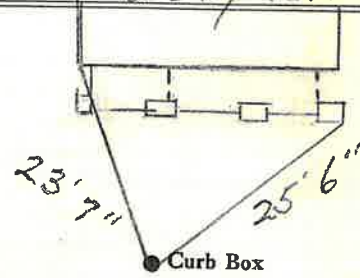

4" C.I. Main Elev. of Main at tap 2'8"

Gate at ● ● Gate at

● Curb Box