


### LABOR AND MATERIALS

Copper	} Connection		\$
Lead			
Curb	} Cock Valve T. S. & V.	in.	\$
Service Box	} Short 3 1/2 x 4 1/2 Long 4 1/2 x 5 1/2 Buff. or Rdway		\$
Old returned			
Ft. in.	} Copper Galv Iron Cast Iron	Pipe at	\$
Nipples	in. at		\$
Bushings	to in. at		\$
Red'g Inc'g	} Couplings	to in. at	\$
Union	in. at		\$
Meter	in. at		\$
Lead Joints	at		\$
Leadite Joints	at		\$
Hrs. Foreman	at		\$
Hrs. Chauffeur	at		\$
Hrs. Tapper	at		\$
Hrs. Labor	at		\$
Hrs. Labor	at		\$
Hrs. Compressor	at		\$
Compensation Ins.			\$
Trucking			\$
Builders Use of Water			\$
			\$
			\$
			\$
			\$

St: \_\_\_\_\_  
 Ph: \_\_\_\_\_  
 Ave. No. 18

Name of Owner \_\_\_\_\_

Labor and Mat'l. Report Aug. 22 1933

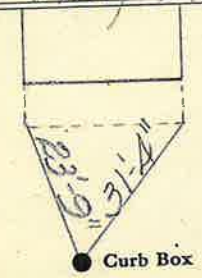

Main Elev. of Main at tap. \_\_\_\_\_

---

Gate at ● ● Gate at

● Curb Box