


| Labor and Materials | | |
|---------------------|---|----|
| 1 | Lead Connection ^{3/4} | \$ |
| 1 | Curb Cock ^{3/4} | \$ |
| 1 | Service Box (Short 3 1/2 x 4 1/2) Old returned (Long 4 1/2 x 5 1/2) Buffalo | \$ |
| 22 | Ft. ^{3/4} in. G. I. Pipe at ^{exp} | \$ |
| | Nipples.....in. at | \$ |
| | Bushings.....to.....in. at | \$ |
| | Red'g Coup.....to.....in. at | \$ |
| | Inc'g Coup.....to.....in. at | \$ |
| | Union.....in. at | \$ |
| | Meter.....in. at | \$ |
| | Cu. Yds. Br. Stone at | \$ |
| | Cu. Yds. Sand at | \$ |
| | Bags Cement at | \$ |
| | Paving Brick (Mack Red Asphalt) } at | \$ |
| 1 | Hrs. Foreman at | \$ |
| 5 | Hrs. Common Labor at | \$ |
| | Hrs. Mason at | \$ |
| | Hrs. ¹ at | \$ |
| | Hrs. ¹ at | \$ |
| yes | Builders' Use of Water | \$ |
| | ^{Truck 100} at | \$ |
| | at | \$ |
| | at | \$ |
| | at | \$ |
| | Total | \$ |

Labor and Material Report *Sep 3 1923*

19 LAWTON ST +
NEW HOUSE

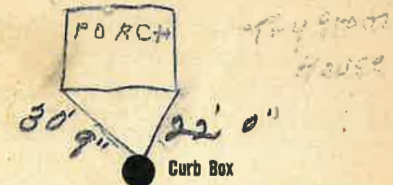

4" Main Elev. of Main at tap *J*

Gate at ● ● Gate at

● Curb Box

TAX ID # 303.13-8-31