

## LABOR AND MATERIALS

Copper	Lead	Connection	3/4		\$ 2.94
1. Curb	Cock Valve		3/4 in.		\$ 3.71
	T. S. & V.				
1. Service box	Short 3/2 X 4 1/2				\$ 5.90
Old returned	Long 4 1/2 X 5 1/2				
	Buf or Rdway				
16' 3/4 in.	Copper	Pipe at	30		\$ 4.40
	C. I.				
Nipples	in. at				\$
Bushings	to in. at				\$
Red'g					
Inc'g	Coupl'gs to in. at				\$
Union	in. at				\$
Meter	in. at				\$
Lead Joints	at				\$
Compound Joints	at				\$
3. Hrs. Water Maint. Man-1	at	1.01			\$ 3.03
Hrs. Water Maint. Man-2	at				\$
12. Hrs. Labor	at	80			\$ 9.60
Hrs. Labor	at				\$
Hrs. Compressor	at				\$
Compensation Ins.	at \$ per C.	28			\$
Trucking					\$ 1.00
Pav't Patch					\$ 11.30
<i>Top by M. G. Wilson</i>					
O'head					\$
					\$ 42.56

114

St.  
Pl.  
Ave. No. 20


*Lowton*

Name of Owner

*Kelly*

Labor and Mat'l. Report

*Aug 20* 19 *48*

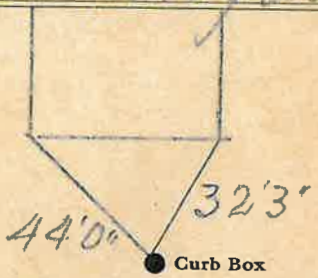

4 Main

Elev. of  
Main at tap 8

Gate at ●

● Gate at

TAX ID # 303.13-8-27

● Curb Box