

LABOR AND MATERIALS

1	Copper Lead	Connection	3/4"	\$	2.41
1	Curb	Cock Valve T.S. & V.	3/4 in.	\$	3.41
Same	Service box	Short 3 1/2 x 4 1/2			
	Old returned	Long 4 1/2 x 5 1/2			
		Buff or Rdway		\$	
17	Ft. 3/4 in.	Copper G.I. G.I.	Pipe at 40	\$	6.80
	Nipples	in. at		\$	
	Bushings	to in. at		\$	
	Red'g Inc'g	Coupl'gs to in. at		\$	
	Union	in. at		\$	
	Meter	in. at		\$	
	Lead Joints	at		\$	
	Compound Joints	at		\$	
	Maintenance Foreman			\$	16.47
	Hrs. Water Maint. Man-1	at		\$	
6	Hrs. Water Maint. Man-2	at		\$	7.44
	Hrs. Garage Foreman	at		\$	
8	Hrs. Labor	at 113		\$	9.04
	Hrs. Compressor	at		\$	
	Compensation Ins. at	\$3.861 per C		\$	64
	Trucking			\$	6.50
	Pav't Patch			\$	6.75
	Tap by Gissoid	6-2-54		\$	
	O'head			\$	
				\$	37.99


31.24

31-54

Lawton St. Pl. Ave. No. 22

Name of Owner
John F. Farrell

Labor and Mat'l. Report June 2 1954

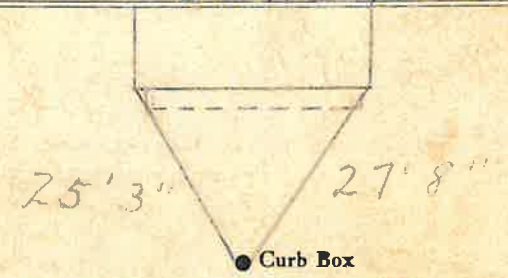

4" Main Elev. of Main at top 4'

Gate at • • Gate at

• Curb Box