

LABOR AND MATERIALS

1	Copper Lead	Connection	3/4"	\$	2.41
1	Curb	Cock Valve T.S. & V.	3/4 in.	\$	3.41
Same	Service box	Short 3 1/2 x 4 1/2			
	Old returned	Long 4 1/2 x 5 1/2			
		Buff or Rdway		\$	
17	Ft.	3/4 in. Copper G.I. C.I.	Pipe at 40	\$	6.80
	Nipples	in. at		\$	
	Bushings	to in. at		\$	
	Red'g Inc'g	Coupl'gs to in. at		\$	
	Union	in. at		\$	
	Meter	in. at		\$	
	Lead Joints	at		\$	
	Compound Joints	at		\$	
	Maintenance Foreman			\$	
	Hrs. Water Maint. Man	1 at		\$	
6	Hrs. Water Maint. Man	2 at		\$	7.44
	Hrs. Garage Foreman	at		\$	
8	Hrs. Labor	at 113		\$	9.04
	Hrs. Compressor at			\$	
	Compensation Ins. at	3.861 per C		\$	64
	Trucking			\$	
	Pay't Patch			\$	6.75
Tap by Gissord 6-2-54					
	O'head			\$	
				\$	37.99

31.24

119


St.  
Pl.  
Ave. No. 24

Lawton

Name of Owner

Conley

Labor and Mat'l. Report Sept 2 1948

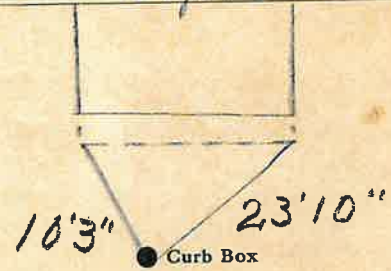

4 Main Elev. of Main at top 4  
Gate at ● Gate at ●

● Curb Box