

Labor and Materials


Copper	Connection	3	\$ 2.60
Lead			
Curb	Cock Valve T. S. & W.	3/4	\$ 2.27
Service Box	Short 3/4x1 1/2		
Old returned	Long 1 1/2x3/4		\$ 1.35
	Buff. or Rdway		
18	Ft. in. Copper Galv. Iron Cast Iron		\$ 2.24
	Nipples in. at		\$
	Bushings to in. at		\$
	Red'g Inc'g Couplings to in. at		\$
	Union in. at		\$
	Meter in. at		\$
	Lbs. Br. Stone at		\$
	Lbs. Sand at		\$
	Bags Cement at		\$
	Paving Brick Mack Red Asphalt at		\$
	Lead Joints at		\$
	Leadite Joints at		\$
8	Hrs. Foreman at		\$ 5.-
3	Hrs. Common Labor Taper at		\$ 1.50
4	Hrs. Common Labor at		\$ 1.80
	Hrs. Mason at		\$
	Hrs. Mason's Helper at		\$
	Hrs. Compressor at		\$
	Compensation Ins		\$.26
	Trucking		\$ 1.-
	Builders' Use of Water Patch (h. Sumer)		\$ 2.50
Total \$			21.55

532-14

Labor and Material Report

Apr 4 1922

5 Hampton Ave

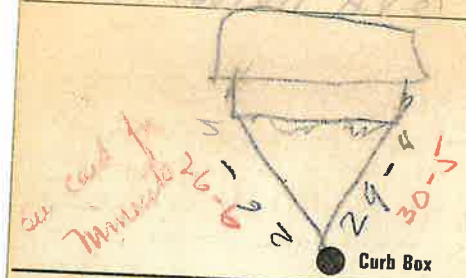

4 Main
 Gate at ● Eley of Main at tap 4 ● Gate at

● Curb Box

New house