

LABOR AND MATERIALS

Copper	}	Connection			\$	
Lead						
Curb	}	Cock Valve T. S. & V.			\$	
Service Box			}	Short 3/2x4 1/2		
Old returned				Long 4 1/2x5 1/2		
		Buff. or Rdway			\$	
Ft.		}	Copper	Pipe at	\$	
in.			Galv Iron			
			Cast Iron			
Nipples		in. at		\$		
Bushings		to	in. at	\$		
Red'g Inc'g	}	Couplings	to	in. at	\$	
Union		in. at		\$		
Meter		in. at		\$		
Lead Joints		at		\$		
Leadite Joints		at		\$		
Hrs. Foreman		at		\$		
Hrs. Chauffeur		at		\$		
Hrs. Tapper		at		\$		
Hrs. Labor		at		\$		
Hrs. Labor		at		\$		
Hrs. Compressor		at		\$		
Compensation Ins.				\$		
Trucking				\$		
Builders Use of Water				\$		
				\$		
				\$		
St:

Pl:

Lanton


Ave. No. 7

Name of Owner

Labor and Mat'l. Report

Aug. 22

1939

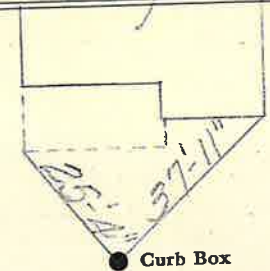

● Curb Box



● Curb Box