

LABOR AND MATERIALS

Copper	Lead	Connection	-----	\$			
		}	Cock	in.	\$		

		}	Valve	in.	\$		

		}	Short	in.	\$		

		}	Long	in.	\$		

		}	Buff. or	Pipe at	\$		

		}	Copper	Pipe at	\$		

		}	Galv Iron	Pipe at	\$		

		}	Cast Iron	Pipe at	\$		

		}	Nipples	in. at	\$		

		}	Bushings	to in. at	\$		

		}	Red'g	Couplings	to in. at		

		}	Inc'g	to in. at	\$		

		}	Union	in. at	\$		

		}	Meter	in. at	\$		

		}	Lead Joints	at	\$		

		}	Leadite Joints	at	\$		

		}	Hrs. Foreman	at	\$		

		}	Hrs. Chauffeur	at	\$		

		}	Hrs. Tapper	at	\$		

		}	Hrs. Labor	at	\$		

		}	Hrs. Labor	at	\$		

		}	Hrs. Compressor	at	\$		

		}	Compensation Ins.	at	\$		

		}	Trucking	at	\$		

		}	Builders Use of Water	at	\$		

S&


Pl.

Ave. No. 8

Lawton

Name of Owner

Labor and Mat'l. Report AUG. 22 1933

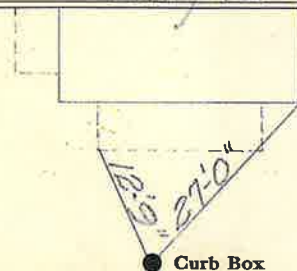

● Curb Box

Main

Elev. of
Main at tap

Gate at ●

● Gate at

● Curb Box