

LABOR AND MATERIALS


1	Copper Lead	Connection	3/4"	\$	3.04
1	Curb	Cock Valve T.S.&V.	3/4 in.	\$	3.54
1	Service box Old returned	Short 3 1/2 x 4 1/2 Long 4 1/2 x 5 1/2 Buff or Rdway		\$	4.70
19	Ft. 3/4 in.	Copper G.I. C.I.	Pipe at 35	\$	6.65
	Nipples	in. at		\$	
	Bushings	to in. at		\$	
	Red'g Inc'g	Coupl'gs to in. at		\$	
	Union	in. at		\$	
	Meter	in. at		\$	
	Lead Joints	at		\$	
	Compound Joints	at		\$	
	Hrs. Water Maint. Man-1	at		\$	
12	Hrs. Water Maint. Man-2	at 113		\$	13.56
14	Hrs. Labor	at 1.02		\$	14.28
	Hrs. Labor	at		\$	
	Hrs. Compressor	at		\$	
	Compensation Ins.	at \$2.66+ per C.		\$	74
	Trucking			\$	1.00
	Pav't Patch			\$	12.15
				\$	
				\$	
				\$	
	O'head			\$	
	Tap by Gifford			\$	59.66
	10-23-51				

10-1951

Lawton Ave. No. 11

Name of Owner CONNOIS

Labor and Mat'l. Report Oct. 23 1951

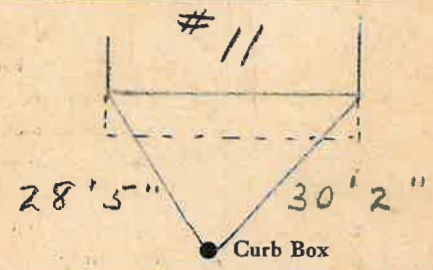

4" Main Elev. of Main at tap 4'

Gate at ● Gate at ●

TAX ID # 303.13-8-35

● Curb Box