

# LABOR AND MATERIALS


Copper } Connection \_\_\_\_\_ \$  
 }  
 Curb } Cock \_\_\_\_\_ \$  
 } Valve \_\_\_\_\_ in. \_\_\_\_\_ \$  
 } T.S. & V. \_\_\_\_\_ \$  
 Service box { Short 3-1/2 x 4-1/2 } \_\_\_\_\_ \$  
 Old returned { Long 4-1/2 x 5-1/2 } \_\_\_\_\_ \$  
 7 Ft. 3/4 in. { Copper } Pipe at \_\_\_\_\_ \$  
 } G.I. \_\_\_\_\_ \$  
 } C.I. \_\_\_\_\_ \$  
 Nipples \_\_\_\_\_ in. at \_\_\_\_\_ \$  
 Bushings \_\_\_\_\_ to \_\_\_\_\_ in. at \_\_\_\_\_ \$  
 Red'g \_\_\_\_\_ \$  
 Inc'g \_\_\_\_\_ \$  
 Union \_\_\_\_\_ in. at \_\_\_\_\_ \$  
 Meter \_\_\_\_\_ in. at \_\_\_\_\_ \$  
 \_\_\_\_\_ \$  
 Compound Joints at \_\_\_\_\_ \$  
 Maintenance Foreman \_\_\_\_\_ \$  
 Hrs. Water Maint. Man - 1 at \_\_\_\_\_ \$  
 Hrs. Water Maint. Man - 2 at \_\_\_\_\_ \$  
 Hrs. Garage Foreman \_\_\_\_\_ at \_\_\_\_\_ \$  
 Hrs. Labor \_\_\_\_\_ at \_\_\_\_\_ \$  
 Hrs. Compressor at \_\_\_\_\_ \$  
 \_\_\_\_\_ \$  
 Trucking \_\_\_\_\_ \$  
 Pav't Patch \_\_\_\_\_ \$  
 \_\_\_\_\_ \$  
 \_\_\_\_\_ \$  
St. \_\_\_\_\_  
 Pl. \_\_\_\_\_  
 Ave. No. 1

1 Leland Dr

Name of Owner \_\_\_\_\_

Labor and Mat'l. Report ~~10~~ 10 / 2005

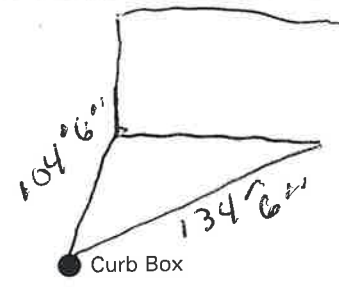

6 Main

Elev. of Main at tap 4

Gate at ●

● Gate at

● Curb Box