


LABOR AND MATERIALS

3/4 Copper } Connection _____ \$ _____
 Curb } Cock _____ \$ _____
 Valve } _____ in. _____ \$ _____
 T.S. & V. }
 Service box { Short 3-1/2 x 4-1/2 } _____ \$ _____
 Old returned { Long 4-1/2 x 5-1/2 } _____ \$ _____
 12 Ft 3/4 in. { Copper } Pipe at _____ \$ _____
 G.I. }
 C.I. }
 Nipples _____ in. at _____ \$ _____
 Bushings _____ to _____ in. at _____ \$ _____
 Red'g _____
 Inc'g _____
 Union _____ in. at _____ \$ _____
 Meter _____ in. at _____ \$ _____
 _____ \$ _____
 Compound Joints at _____ \$ _____
 Maintenance Foreman _____ \$ _____
 Hrs. Water Maint. Man - 1 at _____ \$ _____
 Hrs. Water Maint. Man - 2 at _____ \$ _____
 Hrs. Garage Foreman _____ at _____ \$ _____
 Hrs. Labor _____ at _____ \$ _____
 Hrs. Compressor at _____ \$ _____
 _____ \$ _____
 Trucking _____ \$ _____
 Pav't Patch _____ \$ _____
 _____ \$ _____
 _____ \$ _____
 _____ \$ _____

Leland St. _____
 Ave. No. 3
 Name of Owner _____

Labor and Mat'l. Report 8-19-05

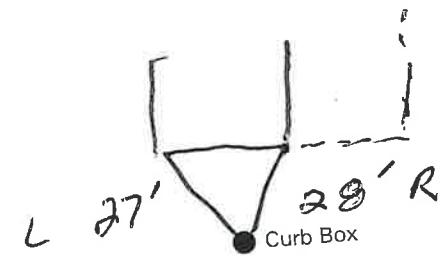

6 Main Elev. of Main at tap 4'
 Gate at • Gate at •

Sewer Right side
 BY ~~_____~~
 OUTSIDE Clean out