

LABOR AND MATERIALS


Copper } Connection _____ \$ _____
 Lead }
 Curb } Cock Valve } _____ in. \$ _____
 T.S. & V. }
 Service box { Short 3-1/2 x 4-1/2 } _____ \$ _____
 Old returned { Long 4-1/2 x 5-1/2 }
 18 Ft. 1" in. { Copper } Pipe at. _____ \$ _____
 G.I. }
 C.I. }
 Nipples _____ in. at _____ \$ _____
 Bushings _____ to _____ in. at _____ \$ _____
 Red'g _____
 Inc'g _____
 Union _____ in. at _____ \$ _____
 Meter _____ in. at _____ \$ _____
 _____ \$ _____
 Compound Joints at _____ \$ _____
 Maintenance Foreman _____ \$ _____
 Hrs. Water Maint. Man - 1 at _____ \$ _____
 Hrs. Water Maint. Man - 2 at _____ \$ _____
 Hrs. Garage Foreman _____ at _____ \$ _____
 Hrs. Labor _____ at _____ \$ _____
 Hrs. Compressor at _____ \$ _____
 _____ \$ _____
 Trucking _____ \$ _____
 Pav't Patch _____ \$ _____
 _____ \$ _____
 _____ \$ _____
LELAND DR. ^{ST.}
^{PT.} 7-9
 Ave. No.

Name of Owner
 LARRY CLUTE

Labor and Mat'l. Report ~~79~~ 2006

OVERHEAD
 DOORS

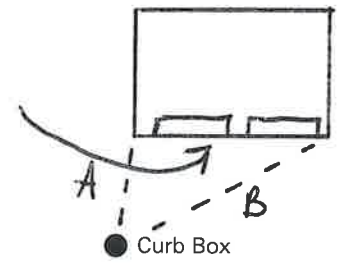

_____ Main Elev. of Main at tap _____
 Gate at ● Gate at ●

 ● Curb Box

A = 38'
 B = 55'6"