

LABOR AND MATERIALS


Copper	} Connection		\$	
Lead				
Curb	} Cock Valve	} in.	\$	
				T. S. & V.
Service box	} Short 3½ x 4½	}	\$	
Old returned				Long 4½ x 5½
11 Ft. ¾ in.	} Copper G.I. G.I.	} Pipe at	\$	
Nipples				in. at
Bushings				to in. at
Red'g	} Coupl'gs	} to in. at	\$	
Inc'g				
Union	in. at	\$		
Meter	in. at	\$		
Compound Joints	at	\$		
Maintenance Foreman		\$		
Hrs. Water Maint. Man-1	at	\$		
Hrs. Water Maint. Man-2	at	\$		
Hrs. Garage Foreman	at	\$		
Hrs. Labor	at	\$		
Hrs. Compressor	at	\$		
Trucking		\$		
Pav't Patch		\$		
		\$		
		\$		
		\$		
		\$		

Leonard

St.
Pl.
Ave. No. 27

Name of Owner _____

Labor and Mat'l. Report 19 89

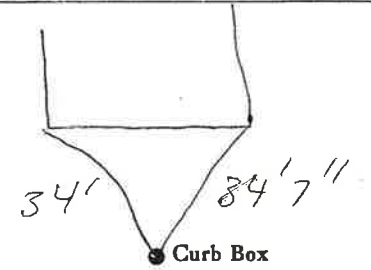

● Curb Box

Main	Elev. of Main at tap
Gate at ●	● Gate at

● Curb Box

New saw line
3/22/10 4" SDR 35
Taym + G.W.T.P.