

LABOR AND MATERIALS

Copper	} Connection	_____	\$ _____	
Lead				
Curb	} Cock } Valve } T. S. & V.	_____ in.	\$ _____	
Service box		} Short 3 1/2 x 4 1/2 } Long 4 1/2 x 5 1/2		
Old returned				\$ _____
40 Ft. 3/4 in.	} Copper } C.I. } C.I.	Pipe at _____	\$ _____	
Nipples		_____ in. at _____	\$ _____	
Bushings		_____ to _____ in. at _____	\$ _____	
Red'g Inc'g	} Coupl'gs	_____ to _____ in. at _____	\$ _____	
Union		_____ in. at _____	\$ _____	
Meter	_____ in. at _____	\$ _____		
Compound Joints	at _____	\$ _____		
Maintenance Foreman		\$ _____		
Hrs. Water Maint. Man-1	at _____	\$ _____		
Hrs. Water Maint. Man-2	at _____	\$ _____		
Hrs. Garage Foreman	at _____	\$ _____		
Hrs. Labor	at _____	\$ _____		
Hrs. Compressor	at _____	\$ _____		
Trucking		\$ _____		
Pav't Patch		\$ _____		
		\$ _____		
		\$ _____		
		\$ _____		
		\$ _____		


Leonard

St. ~~Pl.~~ Ave. No. 34

Name of Owner

Labor and Mat'l. Report

19 90

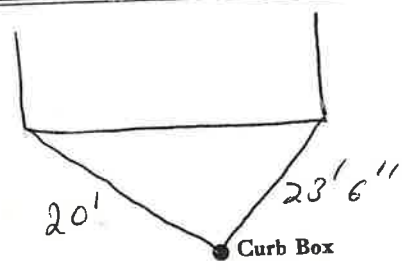

6" Main

Elev. of Main at tap 5'

Gate at ●

● Gate at

● Curb Box

Curb box - 4' depth