

LABOR AND MATERIALS

1	Copper Lead	Connection $\frac{3}{4}$	\$ 1.35
1	Curb	Cock Valve T. S. & V. $\frac{3}{4}$ in.	\$ 1.88
1	Service Box Old returned	Short $3\frac{1}{2} \times 4\frac{1}{2}$ Long $4\frac{1}{2} \times 5\frac{1}{2}$ Buffer Rdway	\$ 1.82
10	Ft. $\frac{3}{4}$ in.	Copper Galv Iron Cast Iron	Pipe at 70 \$ 2.00
	Nipples	in. at	\$
	Bushings	to in. at	\$
	Red'g Inc'g	Couplings to in. at	\$
	Union	in. at	\$
	Meter	in. at	\$
	Lead Joints	at	\$
	Leadite Joints	at	\$
	Hrs. Foreman	at	\$
7	Hrs. Chauffeur	at 6 $\frac{3}{4}$	\$ 4.81
1	Hrs. Tapper	at	\$ 2.75
11	Hrs. Labor	at 55	\$ 6.05
	Hrs. Labor	at	\$
	Hrs. Compressor	at	\$
	Compensation Ins.		\$
	Trucking		\$ 42
	Builders Use of Water	Patch	\$ 1.00
	Tap by <i>Wicks & Co.</i>		\$ 5.00
			\$
			\$
			\$ 27.08

H.

12 1942

St. **35**
No. **19**


LEONARD

Name of Owner

DULEE

Labor and Mat'l. Report

Apr 23 1942

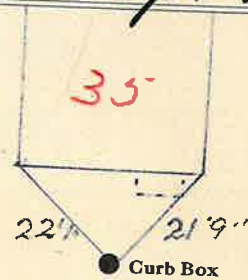

6 Main

Elev. of
Main at tap 5

Gate at ●

● Gate at

● Curb Box