


LABOR AND MATERIALS

1 Copper } Connection $\frac{3}{4}$ " \$
 Lead }
 1 Curb } Clock Valve $\frac{3}{4}$ in. \$
 T. S. & V. }
 1 Service box } Short $3\frac{1}{2}$ X $4\frac{1}{2}$ }
 Old returned } Long $4\frac{1}{2}$ X $5\frac{1}{2}$ }
 Buff. or Rdway } \$
 42 Ft. $\frac{3}{4}$ in. } Copper } Pipe at \$
 Galv. Iron }
 Cast Iron }
 Nipples in. at \$
 Bushings to in. at \$
 Red'g } Couplings to in. at \$
 Inc'g }
 Union in. at \$
 Meter in. at \$
 Lead Joints at \$
 Compound Joints at \$
 Hrs. Foreman at \$
 Hrs. Chauffeur at \$
 Hrs. Tapper at \$
 Hrs. Labor at \$
 Hrs. Labor at \$
 Hrs. Compressor at \$
 Compensation Ins. \$
 Trucking \$
 Builders Use of Water \$
 Top by Gifford \$
 12 Cds. 11-29-62 \$
 \$
 \$
 \$

St. 36 A+B
 Leonard Ave. No.

Name of Owner Noble

Labor and Mat'l. Report Nov. 29 1962

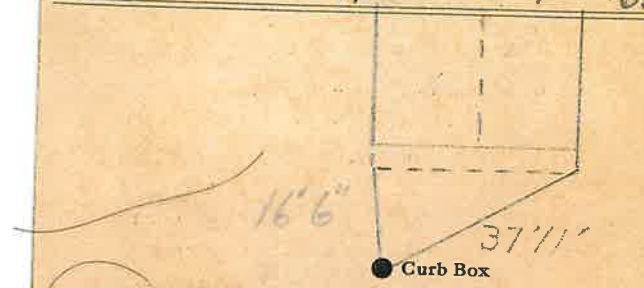

6" C.I. Main
 Elev. of Main at tap 5'
 Gate at ● Gate at ●

● Curb Box