


Labor and Materials

Copper } Connection.....	3	\$ 2.60
Curb } Cock Valve } T.S. & V. } in.....	3	\$ 2.27
Service Box } Short 3/4x4 1/2 } Old returned } Long 4 1/2x5 1/2 } Buff or Redway }		\$ 1.59
7 Ft. in. } Copper } Cast Iron } Pipe at.....	3	\$ 1.26
Nipples..... in. at.....		\$
Bushings..... to..... in. at.....		\$
Red'g } Inc'g } Couplings..... to..... in. at.....		\$
Union..... in. at.....		\$
Meter..... in. at.....		\$
Lbs. Br. Stone at.....		\$
Lbs. Sand at.....		\$
Bags Cement at.....		\$
Paving Brick } Mack } Red } Asphalt } at.....		\$
Lead Joints at.....		\$
Leadite Joints at.....		\$
3 Hrs. Foreman at.....		\$ 1.88
1 Hrs. Common Labor at.....	Tapper	\$ 50
10 Hrs. Common Labor at.....		\$ 4.50
Hrs. Mason at.....		\$
Hrs. Mason's Helper at.....		\$
Hrs. Compressor at.....		\$
Compensation Ins.....		\$.21
Trucking.....		\$ 1. -
Builders' Use of Water.....	Patch	\$ 5. -
Total		\$ 20.81

31-216 41-41R Oct. 12 1931
 Labor and Material Report

25-27 Leonard St.

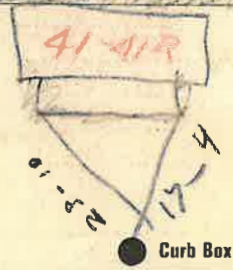

6 Main Eley of Main at tap 6
 Gate at ● Gate at ●

● Curb Box

Old tap dis-
 connected.

23' 10"

17' 4"