


**Labor and Materials**

↑	Copper	Connection	3/4	\$ 2.60
↑	Curb	Cock Valve P.S. & V.	3/4 in.	\$ 2.30
↑	Service Box	Short 3/4x4 1/2		\$ 1.40
	Old returned	Long 1 1/2x3 3/4		
		Buff. or Red way		
39	Ft.	Copper Galv. Iron Cast Iron	3/4 in.	\$ 10.34
	Nipples	in. at		\$
	Bushings	to in. at		\$
	Red'g Inc'g	Couplings to in. at		\$
	Union	in. at		\$
	Meter	in. at		\$
	Lbs. Br. Stone	at		\$
	Lbs. Sand	at		\$
	Bags Cement	at		\$
	Paving Brick	Mack Red Asphalt at		\$
	Lead Joints	at		\$
	Leadite Joints	at		\$
3	Hrs.	Foreman at		\$ 1.88
3.2	Hrs.	Common Labor at		\$ 3.00
	Hrs.	Common Labor at		\$
	Hrs.	Mason at		\$
	Hrs.	Mason's Helper at		\$
	Hrs.	Compressor at		\$
	Compensation Ins.			\$ 3.9
	Trucking			\$ 1.09
	Builders' Use of Water	Patch		\$ 5.00
Total				\$ 37.11

29-36 6  
 Labor and Material Report April 30 1929

2 Leonard St

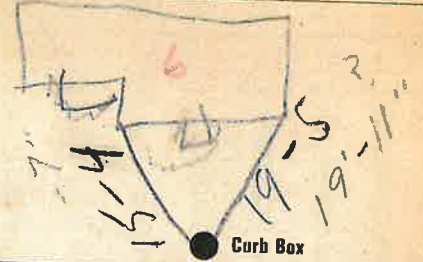

4 Main Eley of Main at tap 5  
 Gate at ● Gate at ●

● Curb Box

New Tap  
 3 holes in SI- to be repaired