

27-107


43

Labor and Material Report

July 6

1924

29 Leonard St.

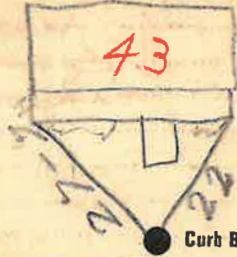

6 Main

Elev. of Main at tap

Gate at

TAX ID # 303.17-5-12

Gate at

Curb Box

Old tap disconnected

Labor and Materials

Copper } Connection	?	\$ 3.20
Curb { Cock Valve } T. S. & V. }	3/4 in.	\$ 1.50
Service Box } Old returned	Short 3/4 x 1/2 } Buff or Relay }	\$ 1.30
2 Ft. } 3/4 in. } Copper } Nipples	3/4 in. at	\$.66
Bushings	to in. at	\$
Red'g } Inc'g } Couplings	to in. at	\$
Union	in. at	\$
Meter	in. at	\$
Lbs. Br. Stone	at	\$
Lbs. Sand	at	\$
Bags Cement	at	\$
Paving Brick	{ Mack Red Asphalt } at	\$
Lead Joints	at	\$
Leadite Joints	at	\$
3 Hrs. Foreman	at	\$ 1.87
1 Hrs. Common Labor	at	\$.59
13 Hrs. Common Labor	at	\$ 5.28
Hrs. Mason	at	\$
Hrs. Mason's Helper	at	\$
Hrs. Compressor	at	\$
Compensation Ins.		\$.20
1 Trucking		\$ 1.50
Builders' Use of Water		\$

Total \$ 15.01