

## LABOR AND MATERIALS

1	Copper Connection $\frac{3}{4}$	\$ 1.79	
	Lead		
1	Curb { Clock Valve } $\frac{3}{4}$ in.	\$ 2.61	
	{ F. S. & V. }		
	Service box	} Same \$ —	
	Old returned		
	{ Short $3\frac{1}{2} \times 4\frac{1}{2}$ Long $4\frac{1}{2} \times 5\frac{1}{2}$ Buff or Rdway		
6	Ft. $\frac{3}{4}$ in. { Copper Galv. Iron } Pipe at 23	\$ 1.38	
	{ Cast Iron }		
	Nipples in. at	\$	
	Bushings to in. at	\$	
	Red'g } Couplings to in. at	\$	
	Inc'g }		
	Union in. at	\$	
	Meter in. at	\$	
	Lead Joints at	\$	
	Compound Joints at	\$	
	Hrs. Foreman at	\$	
10	Hrs. Chauffeur at $8\frac{1}{2}$	\$ 8.25	134
	Hrs. Tapper at	\$	
8	Hrs. Labor at $7\frac{1}{2}$	\$ 5.72	
	Hrs. Labor at	\$	
	Hrs. Compressor at	\$	
	Compensation Ins.	\$ 38	
	Trucking	\$ 1.—	
	Builders Use of Water	\$ 5.00	
	Top by <i>Walschke</i>	\$	
		\$	
		\$	
		\$ 26.13	


15-46

45

St. ~~Pr~~  $\frac{3}{4}$   
 Leonard Ave. No.  $\frac{3}{4}$

Name of Owner  
 Maynikau

Labor and Mat'l. Report July 31 1946

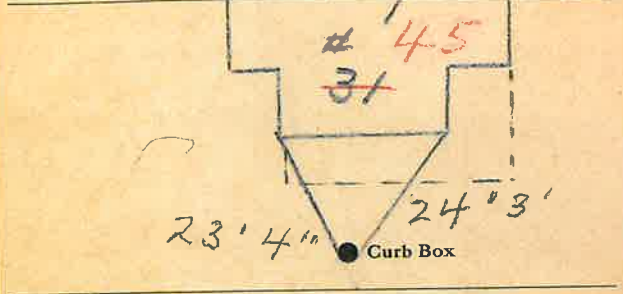

6 Main Elev. of Main at tap 7

Gate at ● Gate at ●

● Curb Box