

LABOR AND MATERIALS

Copper	} Connection	_____	\$	_____				
Lead		_____	\$	_____				
Curb	} Cock	_____ in.	\$	_____				
					} Valve	_____	\$	_____
Service box	} Short 3½ x 4½ }	_____	\$	_____				
Old returned		} Long 4½ x 5½ }	_____	\$	_____			
39½ Ft. 5/4 in.	} Copper	} Pipe at	\$	_____				
					} C. I.	} _____	\$	_____
Nipples	_____ in. at	_____	\$	_____				
Bushings	_____ to _____ in. at	_____	\$	_____				
Red'g	} Coupl'gs	_____ to _____ in. at	\$	_____				
Inc'g					} _____	} _____	\$	_____
Union	_____ in. at	_____	\$	_____				
Meter	_____ in. at	_____	\$	_____				
			\$	_____				
Compound Joints	at	_____	\$	_____				
Maintenance Foreman		_____	\$	_____				
Hrs. Water Maint. Man-1	at	_____	\$	_____				
Hrs. Water Maint. Man-2	at	_____	\$	_____				
Hrs. Garage Foreman	at	_____	\$	_____				
Hrs. Labor	at	_____	\$	_____				
Hrs. Compressor	at	_____	\$	_____				
			\$	_____				
Trucking		_____	\$	_____				
Pav't Patch		_____	\$	_____				
			\$	_____				
			\$	_____				

Leonard

St. _____
Pl. _____
Ave. No. 52

Name of Owner _____

Labor and Mat'l. Report

19 87

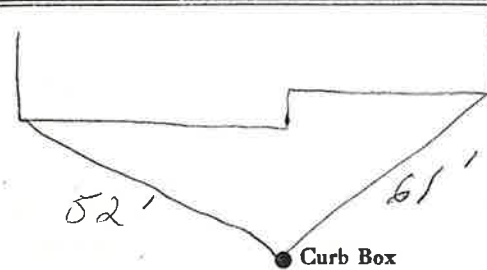

_____ Main _____ Elev. of Main at tap _____
Gate at • _____ • Gate at _____

• Curb Box