

LABOR AND MATERIALS

Copper } Connection _____ \$ _____
 Lead }
 Curb } Cock } _____ in. \$ _____
 } Valve }
 } T. S. & V. }
 Service box { Short 3½ x 4½ }
 Old returned { Long 4½ x 5½ } _____ \$ _____
 37 Ft. ¾ in. { Copper } Pipe at _____ \$ _____
 } G.I. }
 } C.I. }
 Nipples in. at _____ \$ _____
 Bushings to in. at _____ \$ _____
 Red'g }
 Inc'g } Coupl'gs to in. at _____ \$ _____
 Union in. at _____ \$ _____
 Meter in. at _____ \$ _____
 _____ \$ _____
 Compound Joints at _____ \$ _____
 Maintenance Foreman _____ \$ _____
 Hrs. Water Maint. Man-1 at _____ \$ _____
 Hrs. Water Maint. Man-2 at _____ \$ _____
 Hrs. Garage Foreman at _____ \$ _____
 Hrs. Labor- at _____ \$ _____
 Hrs. Compressor at _____ \$ _____
 _____ \$ _____
 Trucking _____ \$ _____
 Pav't Patch _____ \$ _____
 _____ \$ _____
 _____ \$ _____

Leonard

St. _____
 Pl. _____
 Ave. No. 54

Name of Owner

Labor and Mat'l. Report

1989

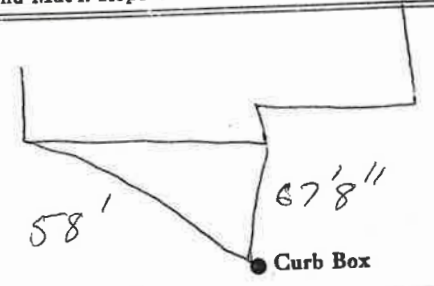

● Curb Box

Main _____ Elev. of Main at top _____

Gate at ● Gate at ●

TAX ID # 303.13-19-2

● Curb Box