

LABOR AND MATERIALS


Copper	} Connection	_____	\$ _____	
Lead				
Curb	} Cock Valve T. S. & V.	_____ in.	\$ _____	
Service box		} Short 3½ x 4½ Long 4½ x 5½	_____	\$ _____
Old returned				
41 Ft. 3/4 in.	} Copper G.I. G.I.	Pipe at _____	\$ _____	
Nipples _____ in.		at _____	\$ _____	
Bushings _____ to _____ in.		at _____	\$ _____	
Red'g } Inc'g }	} Coupl'gs	_____ to _____ in.	at _____ \$ _____	
Union _____ in.		at _____	\$ _____	
Meter _____ in.	at _____	\$ _____		
Compound Joints	at _____	\$ _____		
Maintenance Foreman	_____	\$ _____		
Hrs. Water Maint. Man—1	at _____	\$ _____		
Hrs. Water Maint. Man—2	at _____	\$ _____		
Hrs. Garage Foreman	at _____	\$ _____		
Hrs. Labor—	at _____	\$ _____		
Hrs. Compressor	at _____	\$ _____		
Trucking	_____	\$ _____		
Pav't Patch	_____	\$ _____		
		\$ _____		
		\$ _____		
		\$ _____		
		\$ _____		

Leonard

St. Pl. Ave. No. 56

Name of Owner

Labor and Mat'l. Report 19 89

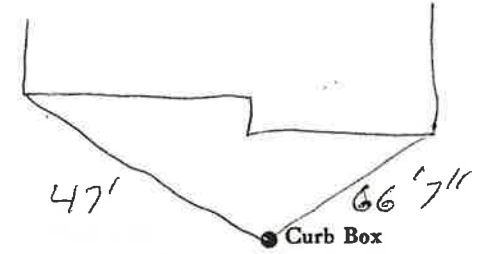

_____ Main	Elev. of Main at tap _____
Gate at ●	● Gate at

● Curb Box