


LABOR AND MATERIALS

Copper	Lead	Connection		\$	
	}	Cock	in.	\$	
Curb		Valve			
		T. S. & V.			
Service box	}	Short 3½ x 4½		\$	
Old returned		Long 4½ x 5½			
10 Ft.	¾ in.	Copper	}	\$	
		C.I.			
		C.I.			
Nipples	in.	at		\$	
Bushings	to	in.	at	\$	
Red'g	}	Coupl'gs.	to	in.	at
Inc'g					
Union	in.	at		\$	
Meter	in.	at		\$	
				\$	
Compound Joints	at			\$	
Maintenance Foreman				\$	
Hrs. Water Maint. Man—1	at			\$	
Hrs. Water Maint. Man—2	at			\$	
Hrs. Garage Foreman	at			\$	
Hrs. Labor—	at			\$	
Hrs. Compressor	at			\$	
				\$	
Trucking				\$	
Pav't Patch				\$	
				\$	
				\$	
				\$	
				\$	

St. 57
 Pt. 57
 Ave. No. 57

Name of Owner Leonard

Labor and Mat'l. Report Oct 19 88

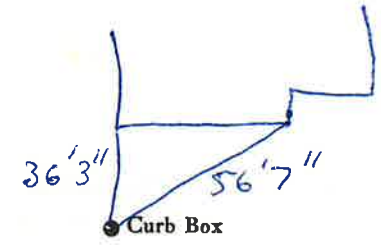

Main Elev. of
Main at tap

Gate at ● ● Gate at

● Curb Box