

### LABOR AND MATERIALS


Copper } Connection _____	\$ _____
Lead } _____	\$ _____
Curb } Cock Valve } _____ in.	\$ _____
} T. S. & V. } _____	\$ _____
Service box { Short 3½ x 4½ }	\$ _____
Old returned { Long 4½ x 5½ }	\$ _____
38 Ft. <sup>3/4</sup> in. { Copper } Pipe at _____	\$ _____
{ G. I. }	\$ _____
{ G. I. }	\$ _____
Nipples _____ in. at _____	\$ _____
Bushings _____ to _____ in. at _____	\$ _____
Red'g } Coupl'gs. _____ to _____ in. at _____	\$ _____
Inc'g } _____	\$ _____
Union _____ in. at _____	\$ _____
Meter _____ in. at _____	\$ _____
_____	\$ _____
Compound Joints at _____	\$ _____
Maintenance Foreman _____	\$ _____
Hrs. Water Maint. Man—1 at _____	\$ _____
Hrs. Water Maint. Man—2 at _____	\$ _____
Hrs. Garage Foreman _____ at _____	\$ _____
Hrs. Labor— _____ at _____	\$ _____
Hrs. Compressor at _____	\$ _____
_____	\$ _____
Trucking _____	\$ _____
Pav't Patch _____	\$ _____
_____	\$ _____
_____	\$ _____
_____	\$ _____
_____	\$ _____

Leonard

St. \_\_\_\_\_  
~~Pl.~~ \_\_\_\_\_  
 Ave. No. 58

Name of Owner \_\_\_\_\_  
 \_\_\_\_\_

Labor and Mat'l. Report \_\_\_\_\_ 19 89

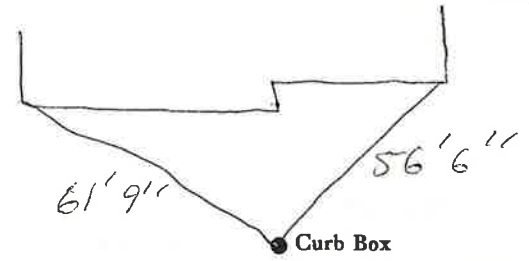

Main Elev. of

Gate at ● Main at tap \_\_\_\_\_

● Gate at

● Curb Box